

46

DRAWING

G/055/93 of 23 May 1993

1. MATERIAL

- |    |             |                                       |
|----|-------------|---------------------------------------|
| a. | Base Cloth  | Blazer ( BCC - 220 )                  |
| b. | Inner Cloth | Woollen Bukram Grade A                |
| c. | Lining      | Binding Cloth Cotton<br>( BCC - 220 ) |

2. MONOGRAM

a. FINGERS

- |      |                    |  |
|------|--------------------|--|
| i.   | Embroidery         | 100% POLYESTER THREAD<br><del>ZARRI</del> (GOLDEN) |
| ii.  | Ankle Out Lines    | Mercerised Thread<br>( BCC - 220 )                 |
| iii. | Flap Toe Out Lines | Mercerised Thread<br>( BCC - 220 )                 |

b. DAGGER

- |      |                    |  |
|------|--------------------|--|
| i.   | Blade (Embroidery) | 100% POLYESTER THREAD<br><del>ZARRI</del> (SILVER) |
| ii.  | Handel Embroidery  | 100% POLYESTER THREAD<br><del>ZARRI</del> (GOLDEN) |
| iii. | Hilt Guard         | 100% POLYESTER THREAD<br><del>ZARRI</del> (GOLDEN) |
|      | Out Line           | Mercerised Thread<br>( BCC - 220 )                 |

3. Make, Shape, Design and Dimensions

As per drawing G/055/93  
of 23 May 1993

Note:- i. Tender sample to be approved by CINS.

ii. ~~Complete badge should be lacquered.~~

ii) EDGES SHOULD BE NEATLY TURNED INSIDE.

\* c. i. Dye Fastness to water washing Test-2  
(ISO- 105- E01) 1978 (E)

GS - 5

ii) Dye Fastness to Dry cleaning  
(ISO- 105- B01)



GS- 5

iii) Dye Fastness to Light  
(ISO- 105- B01)

GS 5 (min)

2



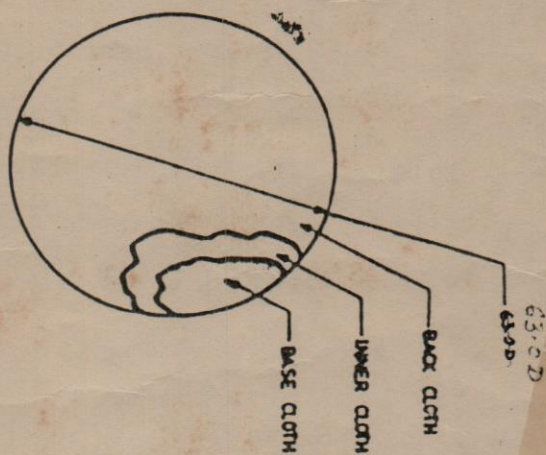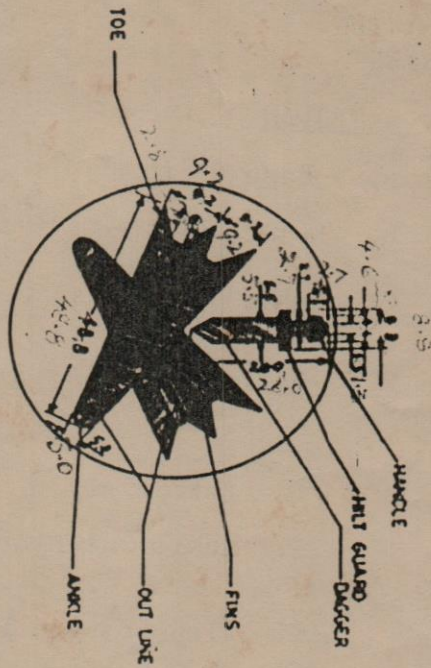

INSPECTORATE OF NAVAL STORES  
11 LIAQUAT BARRACKS KARACHI

MATERIAL:

AS PER TECHNICAL DATA

TITLE: UNIT EMBLEM -SSG (N) - PNS IQBAL

DRAWN BY

DEAN BAGE  
3 MAY 1

CHECKED BY

MAJOR MUHAMMAD  
LT COL PN

APPROVED BY

MAJOR MUHAMMAD  
CAP PN PN  
C.I.N.S